| FABRIEK | KK-155 | E-RVD | | E-RVD | PLC EK-100 |
|---|---|---|---|---|---|

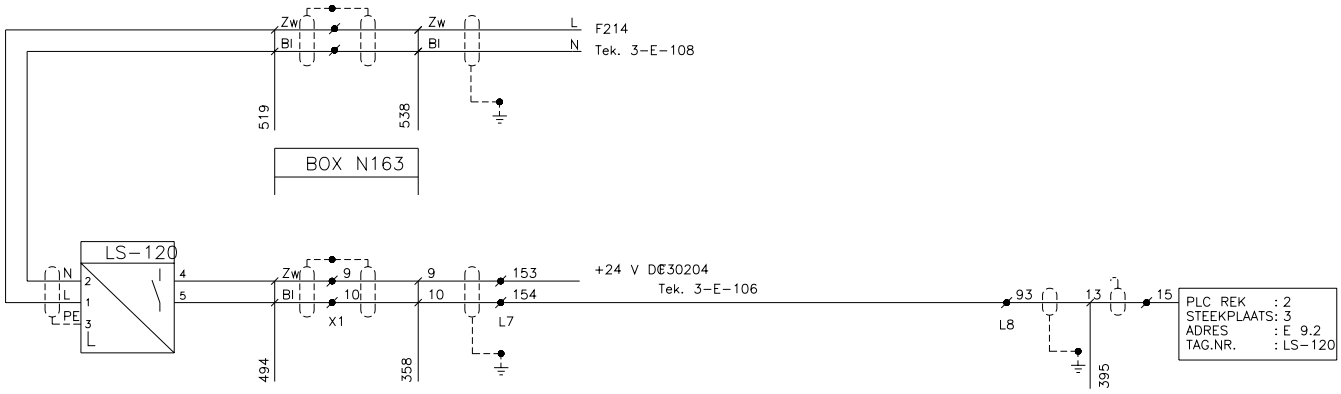


| Rev.: | Date: | Disription: | Drawn by: | Ckd: | Seen by: |
|---|---|---|---|---|---|
| A | 06-09-1994 | FOR APPROVAL | M.V. | J.S. | J.Li |
| B | 14-12-1994 | AS BUILT | P.G. | J.S. | J.Li |

HVL ELEKTROTECHNIEK
POSTBUS 1341
6201 BH MAASTRICHT
043-6190390

Client: LB METREX B.V.
Project: ROOKGAS ONTZWAVELING
Title: HOOK-UP
LAAG NIVEAU SCHAK. B-137
Tag number: L-120

| Drawn by: | Filenumber: | Scale: | Size: | Ordernumber: | Sub.: | Drawing number: | Sht.: | of: | Rev. |
|---|---|---|---|---|---|---|---|---|---|
| P.G. 14-12-1994 | 94120 | - : - | A4 | 9580 | 00 | 3-H-100 | 00000 | 00000 | B |

| LS-120 | E&H FTM-230 | | | | |
|---|---|---|---|---|---|
| TAG Nr.: | Fabrikaat en Type: | Spec./Magn. | Instelling | Meetbereik | Opm./Tek. |

0 10 20 30 40 50 60 70 80 90 100 mm

Demo Version