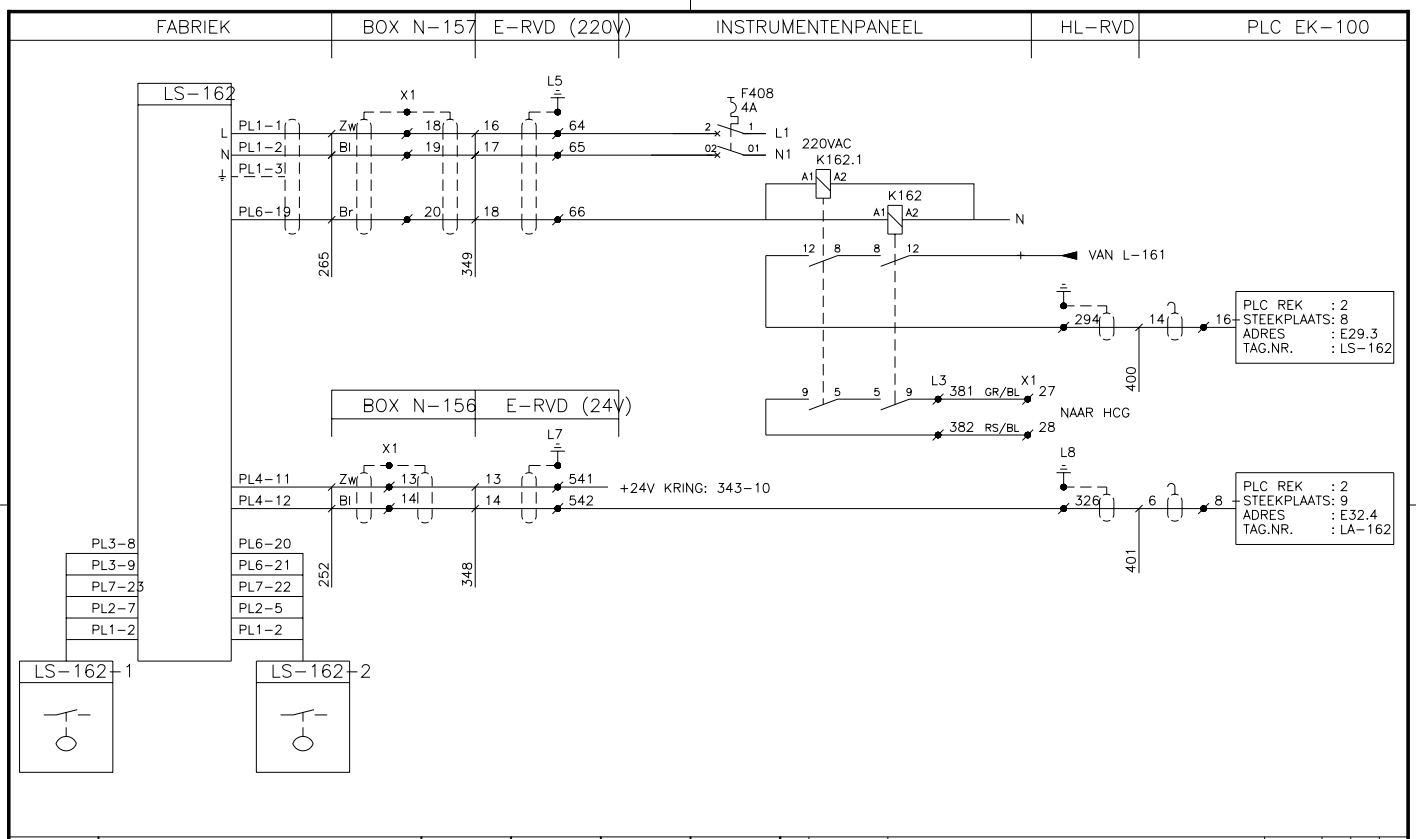

LS-161	ECON MOBREY MAZL 83002				
LS-161-2	ECON MOBREY ACCS 83002				
LS-161-1	ECON MOBREY ACCS 83002				
TAG Nr.:	Fabrikaat en Type:	Spec./Magn.	Instelling	Meetbereik	Opm./Tek.

Rev.:	Date:	Disription:	Drawn by:	Ckd:	Seen by:
A	14-12-1994	AS BUILT	R.B.	J.S.	J.Li
0					

HVL ELEKTROTECHNIEK
POSTBUS 1341
6201 BH MAASTRICHT
043-618090

Client: LB METREX B.V.
Project: WARME STRAAT
Title: HOOK-UP
NIVO NEVENDRUM V-150
Tag number: L-162

Drawn by:	Filenumber:	Scale:	Size:	Ordernumber:	Sub.:	Drawing number:	Sht.:	of:	Rev.
	L-162	- : -	A3	9580	00	3-H-100	00000000		A

0 10 20 30 40 50 60 70 80 90 100 mm

Demo Version