FABRIEK	BOX KK6	HL-RVD	INSTRUMENTEN PANEEL	HL-RVD	PLC EK-100

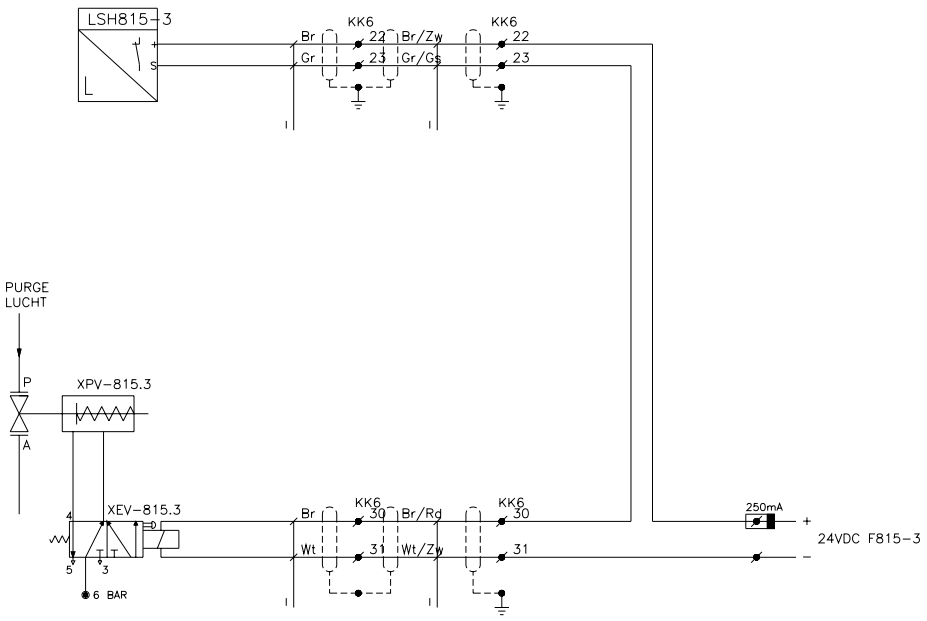

LSH815.3	
XEV815.3	S.I.R.C.A.
XPV815.3	M.V. BALL VALVES

TAG Nr.:	Fabrikaat en Type:	Spec./Magn.	Nmstelling	Meetbereik	Opm./Tek.

Rev.:	Date:	Disription:	Drawn by:	Ckd:	Seen by:
D	14-12-1994	AS BUILT	N.S.	J.S.	J.Li
C	26-10-1993	SEVERAL CHANGES	R.G.	J.S.	J.Li

HVL ELEKTROTECHNIEK
POSTBUS 1541
6201 BH MAASTRICHT
043-6190190

Client: LB METREX B.V.
Project: ROOKGAS ONTZWAVELING
Title: HOOK-UP SCRUBBER C815 IN Z815
Tag number: L815-2

Drawn by:	Filenumber:	Scale:	Size:	Ordernumber:	Sub.:	Drawing number:	Sht.:	of:	Rev.
R.G. 23-08-1994	L815-2	- : -	A3	9580	00	3-H-800	00000	00000	D

0 10 20 30 40 50 60 70 80 90 100 mm

Demo Version